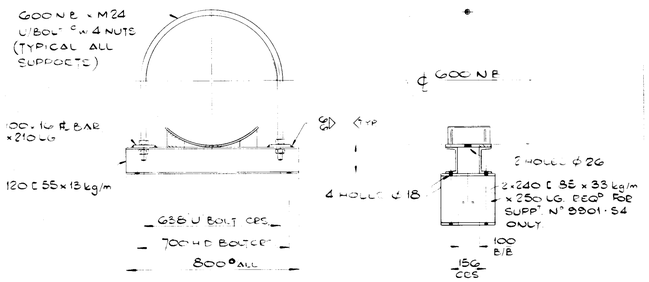

SUPPORT DETAIL

22 OFF REQD MARK 9901-S1
1 OFF REQD MARK 9901-S4

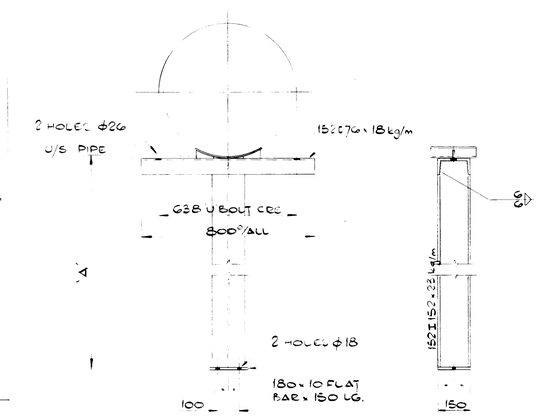

SUPPORT DETAIL

MARK N°	QTY	DIM A
9901-S2	1	1770
9901-S3	1	440
9904-S1	2	3110
9904-S2	1	1340
9902-S4	1	2085

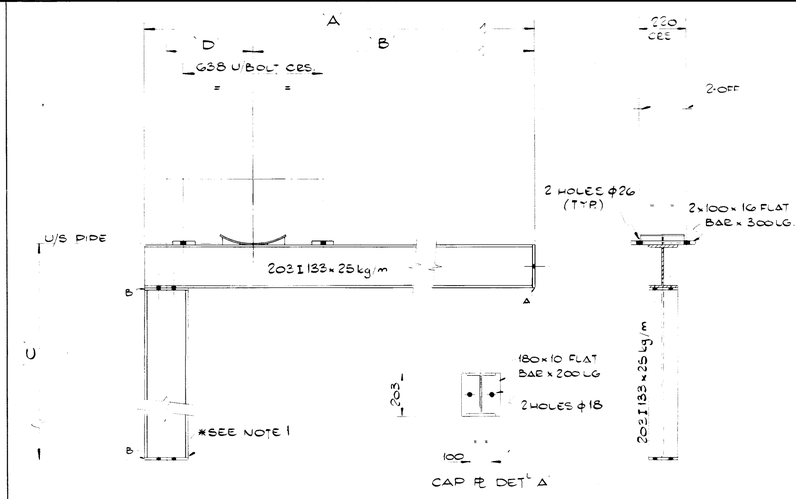

SUPPORT DETAIL

MARK N°	QTY	DIM A	DIM B	DIM C	DIM D
9902-S1	1	4300	3800	800	250
9902-S3	7	3400	2800	1000	500
* 9902-S7	1	3550	3150	300	300 *
9902-S5	4	2600	1500	800	1000
9902-S6	2	4350	1450	800	2800
9902-S7	1	4300	3800	800	400

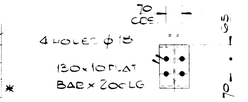

NOTE 1. FOR SUPP' N° 9902-S7 PL MARKED * WILL BE UNDRILLED & WELDED TO EXIS'G. STLWL. ON SITE.

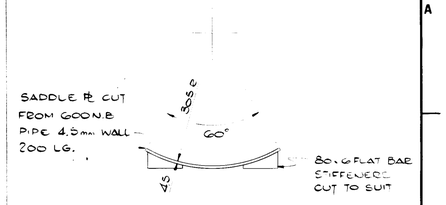

TYPICAL SADDLE PL DETAIL
70 OFF REQD I.E. 1 OFF PER SUPP'

NOTES.
1. FOR GENERAL NOTES REFER TO DRG N° C030-000-3001
2. EACH SUPPORT TO BE CLEARLY MARKED WITH THE MARK N°

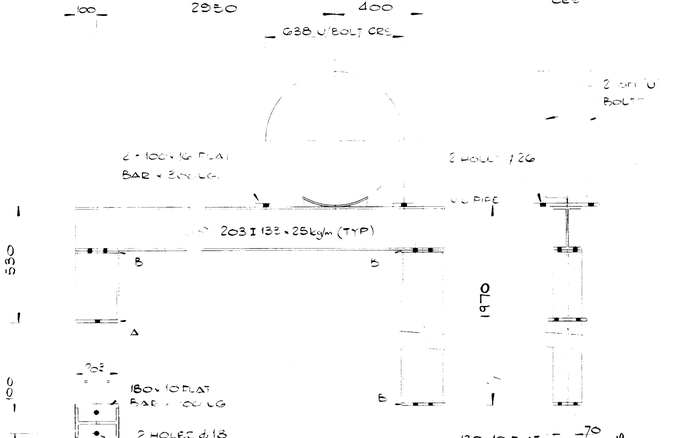

SUPPORT DETAIL

1 OFF REQD MARK N° 9902-S2

SUPPORT DETAIL

14 OFF REQD MARK 9902-S1

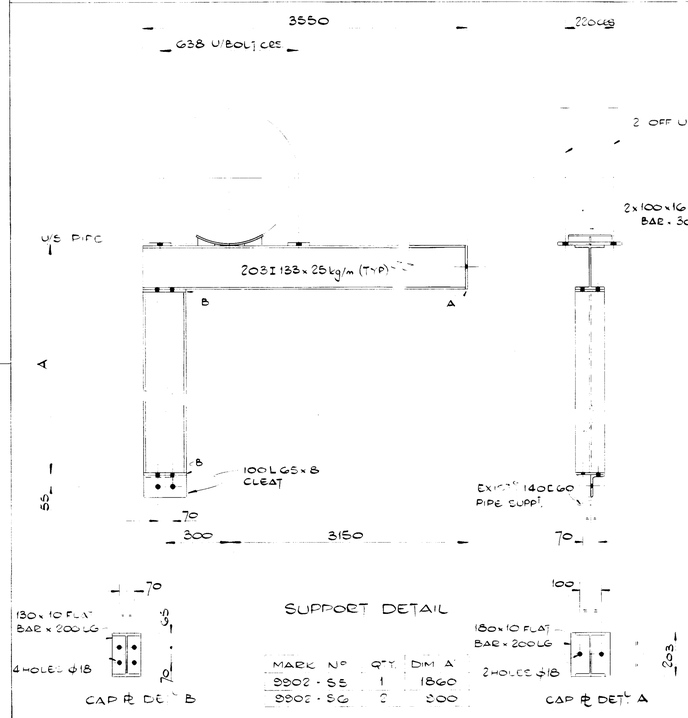

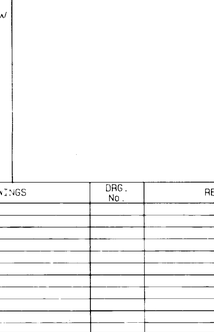

SUPPORT DETAIL

MARK N°	QTY	DIM A
9902-S5	1	1860
9902-S6	2	300

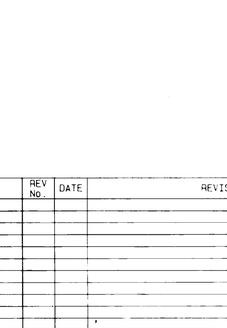

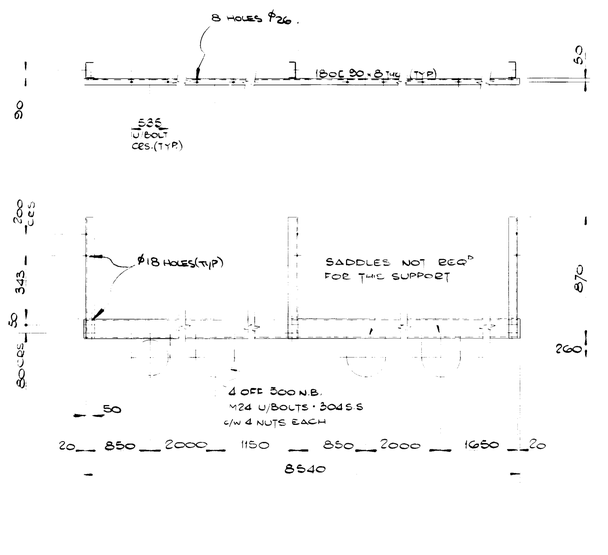

SUPPORT DETAIL

1 OFF REQD MARK N° 9904-S3
MATERIAL: 3 CR 12

DRG. No.	REFERENCE DRAWINGS
C030/000/9901	PIPING GENERAL ARRGT
C030/000/9902	— " — " —
C030/000/9903	— " — " —
C030/000/9904	— " — " —

REV No.	DATE	REVISIONS	REV BY	CHK'D
00	8/8	ISSUED FOR APPROVAL		
01	5/9/88	[illegible]		
02	10/8/88	REVISED TO AS BUILT	AB	

TITACO
LETHABO PS 05-07 88

TITACO CONTRACTING
Engineers and Construction
A Titaco Group Company
Titaco Contracting (Pty) Ltd.
Titaco House
23 de Beer street, Braamfontein 2001
P.O. Box 32102, Braamfontein 2017
Telex 4-26967 SA
Telephone 403-5941
Registration number 84/10584/07

CLIENT : ESCOM | CLIENT : | DATE :
PROJECT : LETHABO PS. JOB N° :
PLANT : C.W. TRANSFER SYSTEM AREA : L.P SERVICES
TITLE : PIPE SUPPORT DETAILS
SCALE :

DRAWN PMS	DATE 9/8/87	MECH:	PIPING:	CIVIL:	PROJ MAN:
CHKD RBP	DATE : 11-8-87	ELEC:	INSTR:	STRUCT:	DATE: 11-8-87

CLIENT DRG. No. : 0.63/27093
TITACO DRG. No. : C 0 3 0 0 0 0 3 0 0 2 REV. 0 2

THIS DRAWING IS THE PROPERTY OF TITACO. IT SHOULD NOT BE COPIED OR USED IN ANY MANNER WHATSOEVER WITHOUT THE PERMISSION OF TITACO IN WRITING. IT SHOULD NOT BE LENT OUT OR SHOWN TO THIRD PARTIES WITHOUT THE SAME PERMISSION BEING OBTAINED FROM TITACO.

Original size A4